


This drawing is copyright and may not be reproduced in whole or part without written authority. Do not scale off this drawing.

REVISIONS	
REV AMENDED TO CHANGE ORDER 014	30/07/01 GH
REV BIROOM N°s 48a & 48b ADDED	12/01/02 MG
REV CLAYOUT REVISED TO RM N°s 48a & 48b	17/01/02 MG
REV CLAYOUT REVISED TO RM N°s 48a & 48b	06/03/02 GH
REV E:20 FIRE DOORS ADDED TO CORRIDORS	20/03/02 GH
REV FIAS BUILT	21/06/02 GH

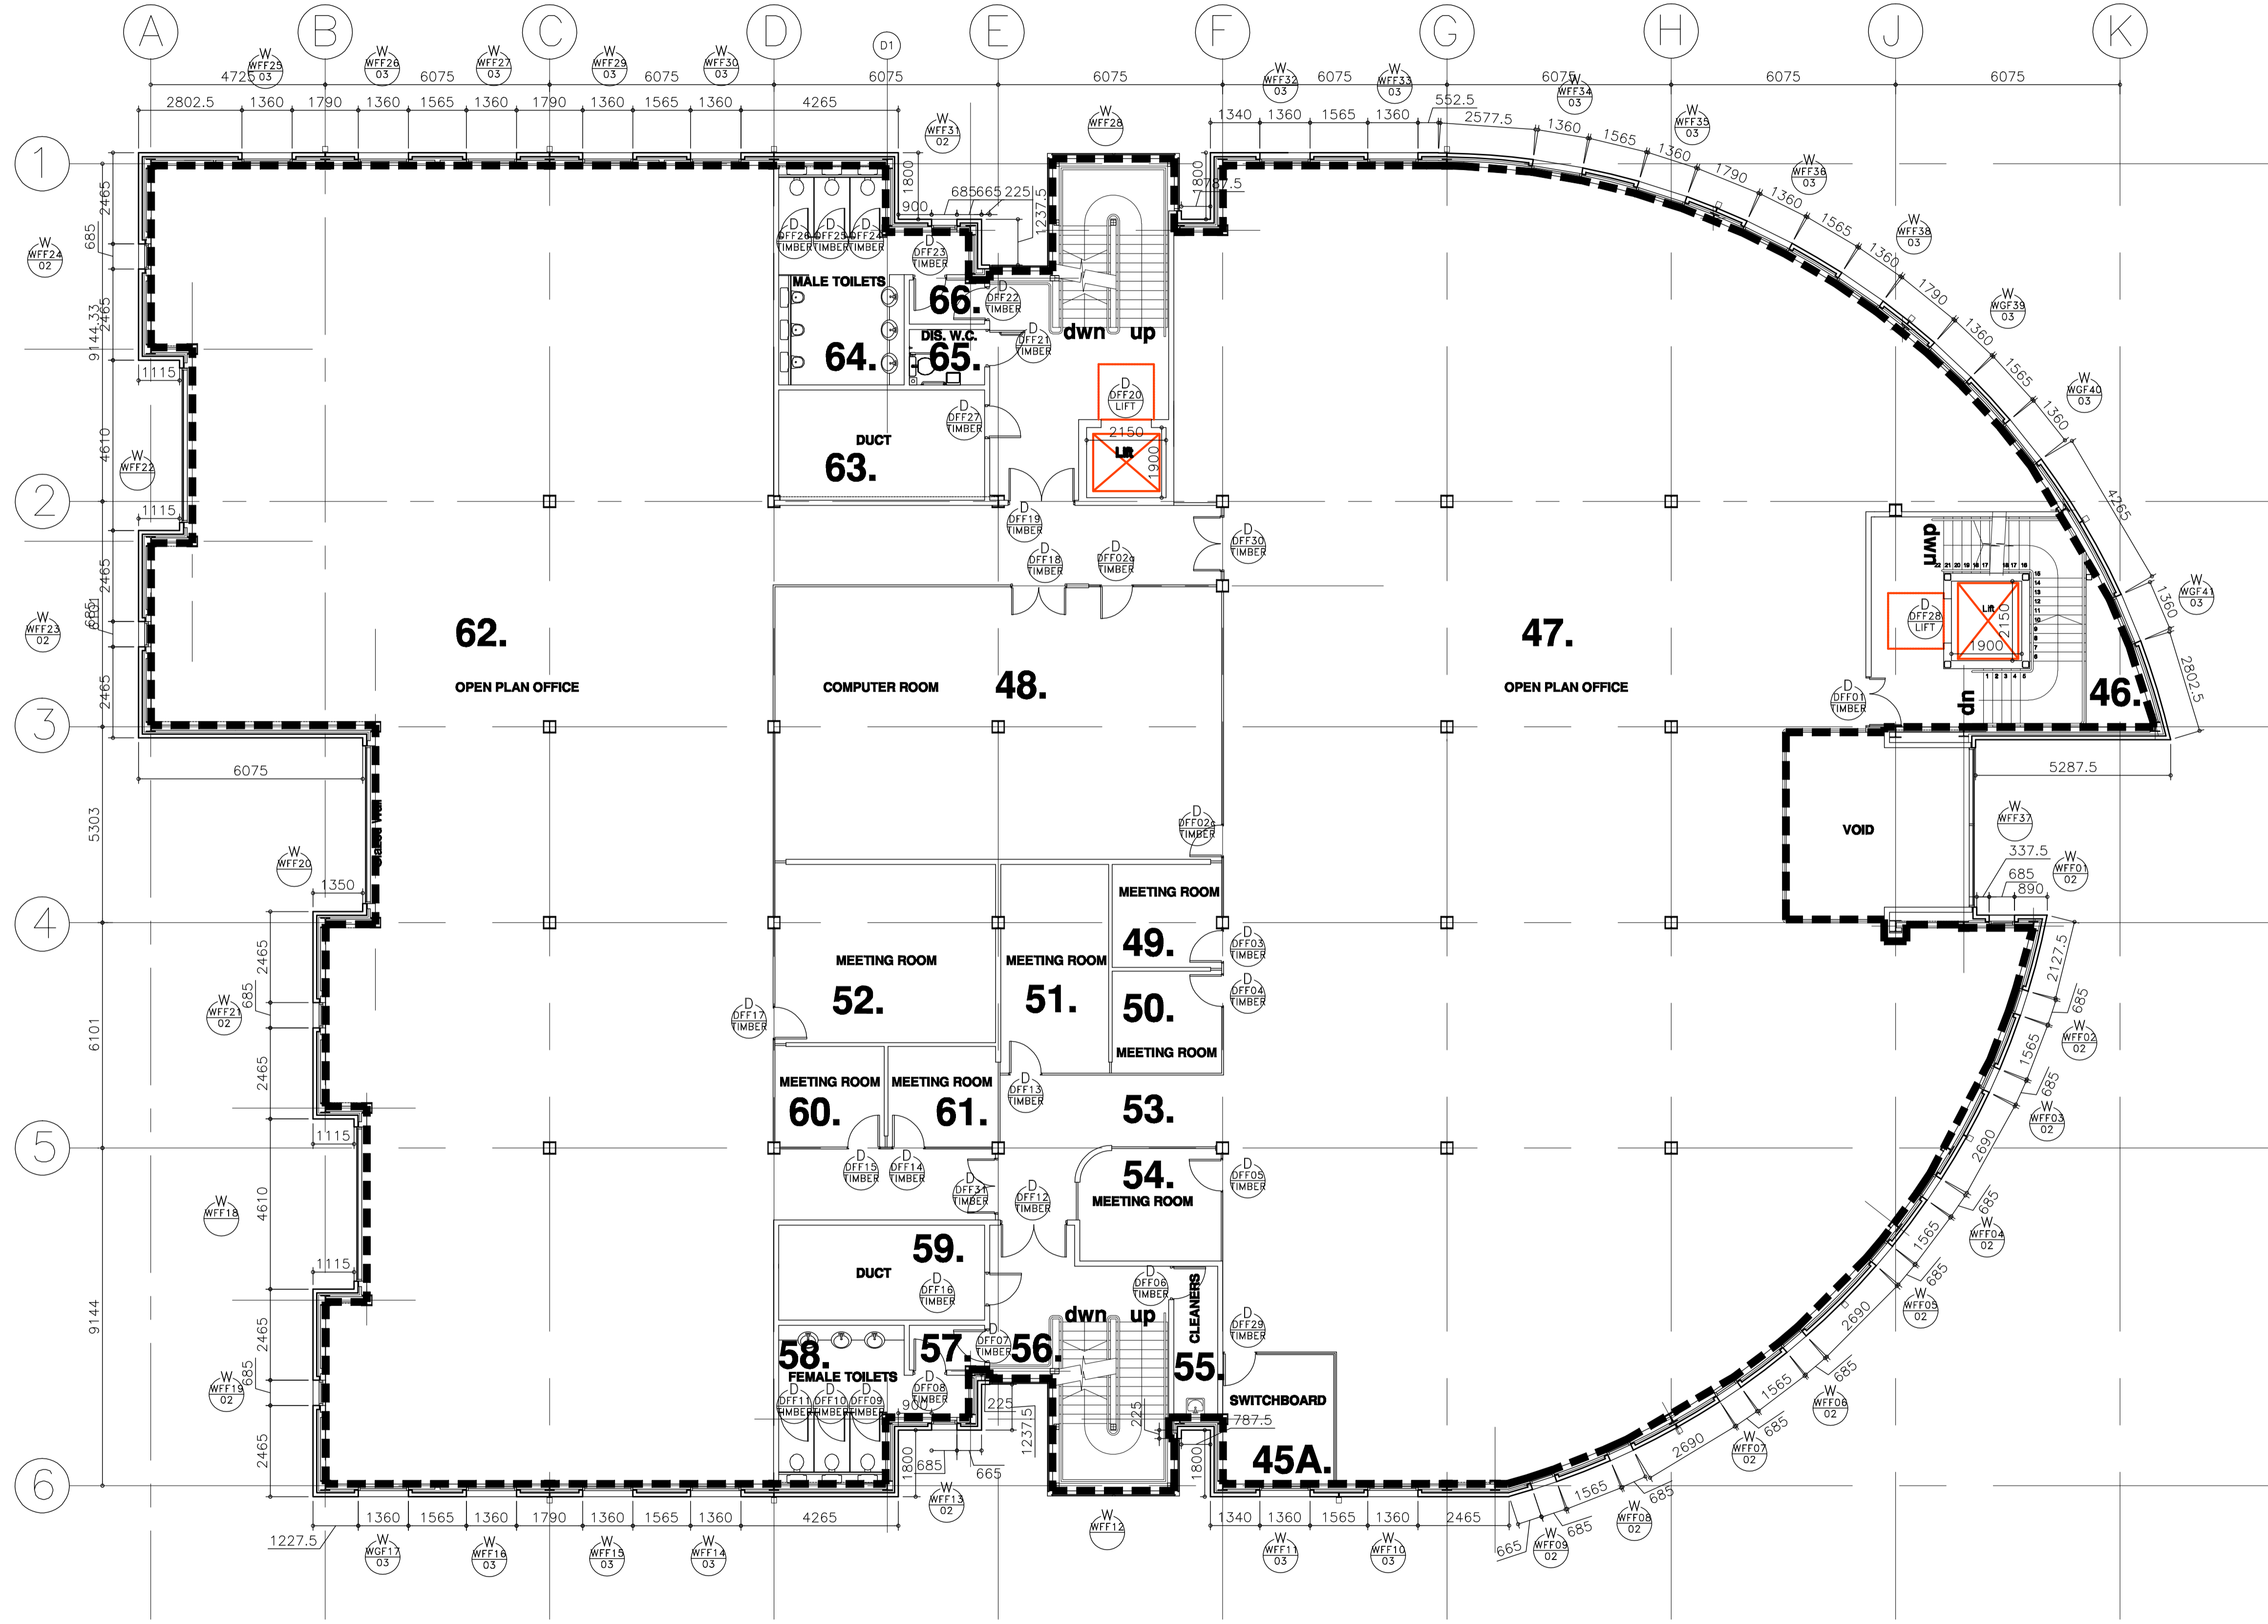

FLOOR AREA 1548 SQM / 16,663 SQFT

AS BUILT DRAWING

PROJECT
PROPOSED OFFICE HEADQUARTERS DEVELOPMENT
 DUNSLOW ROAD
 SCARBOROUGH

CLIENT
S. HARRISON DEVELOPMENTS Ltd.

TITLE
FIRST FLOOR PLAN

JOB NO	DRAWING NO	REVISION
5411	1006	F

DATE
 Feb. 2001

SCALE
 1:100 @ A1

DRAWN
 Michaela

OLD FILE REFERENCE
 j:\projects\5001-6000\5411\construction

24 ST JOHN'S NORTH
 WAKEFIELD WF1 3QA
 Tel: (01924) 291800
 Fax: (01924) 290072
 Email: name@harrispartnership.com



PROJECT MANAGERS • INTERIOR DESIGNERS

ARCHITECTS