


This drawing is copyright and may not be reproduced in whole or part without written authority. Do not scale off this drawing.

REVISIONS
 Rev A: Wall between room N°s 69 & 70 revised to glass 08:00:01 MG
 Rev B: AMENDED TO CHANGE ORDER 003,006 01:08:01 GH
 Rev C: Cavity wall added on Grid line 4 between grid lines F & G to hide vertical bracing 20:08:01 MG
 Rev D: AMENDED TO CHANGE ORDER 008 26:08:01 GH
 Rev E: AMENDED TO CHANGE ORDERS 18:08:01 GH
 Rev F: Door N° 08 & 06, lobbies added in RM N°s 73 & 74 04:01:02 MG
 Rev G: 300mm glass fire added, glazed screen added to room N° 85 14:01:02 MG
 Rev H: Door N°s 12, 13, 15, 16, 38, 39 & 42 revised in accordance with change order N° 025 17:01:02 MG
 Rev J: AS BUILT 21:08:01 GH

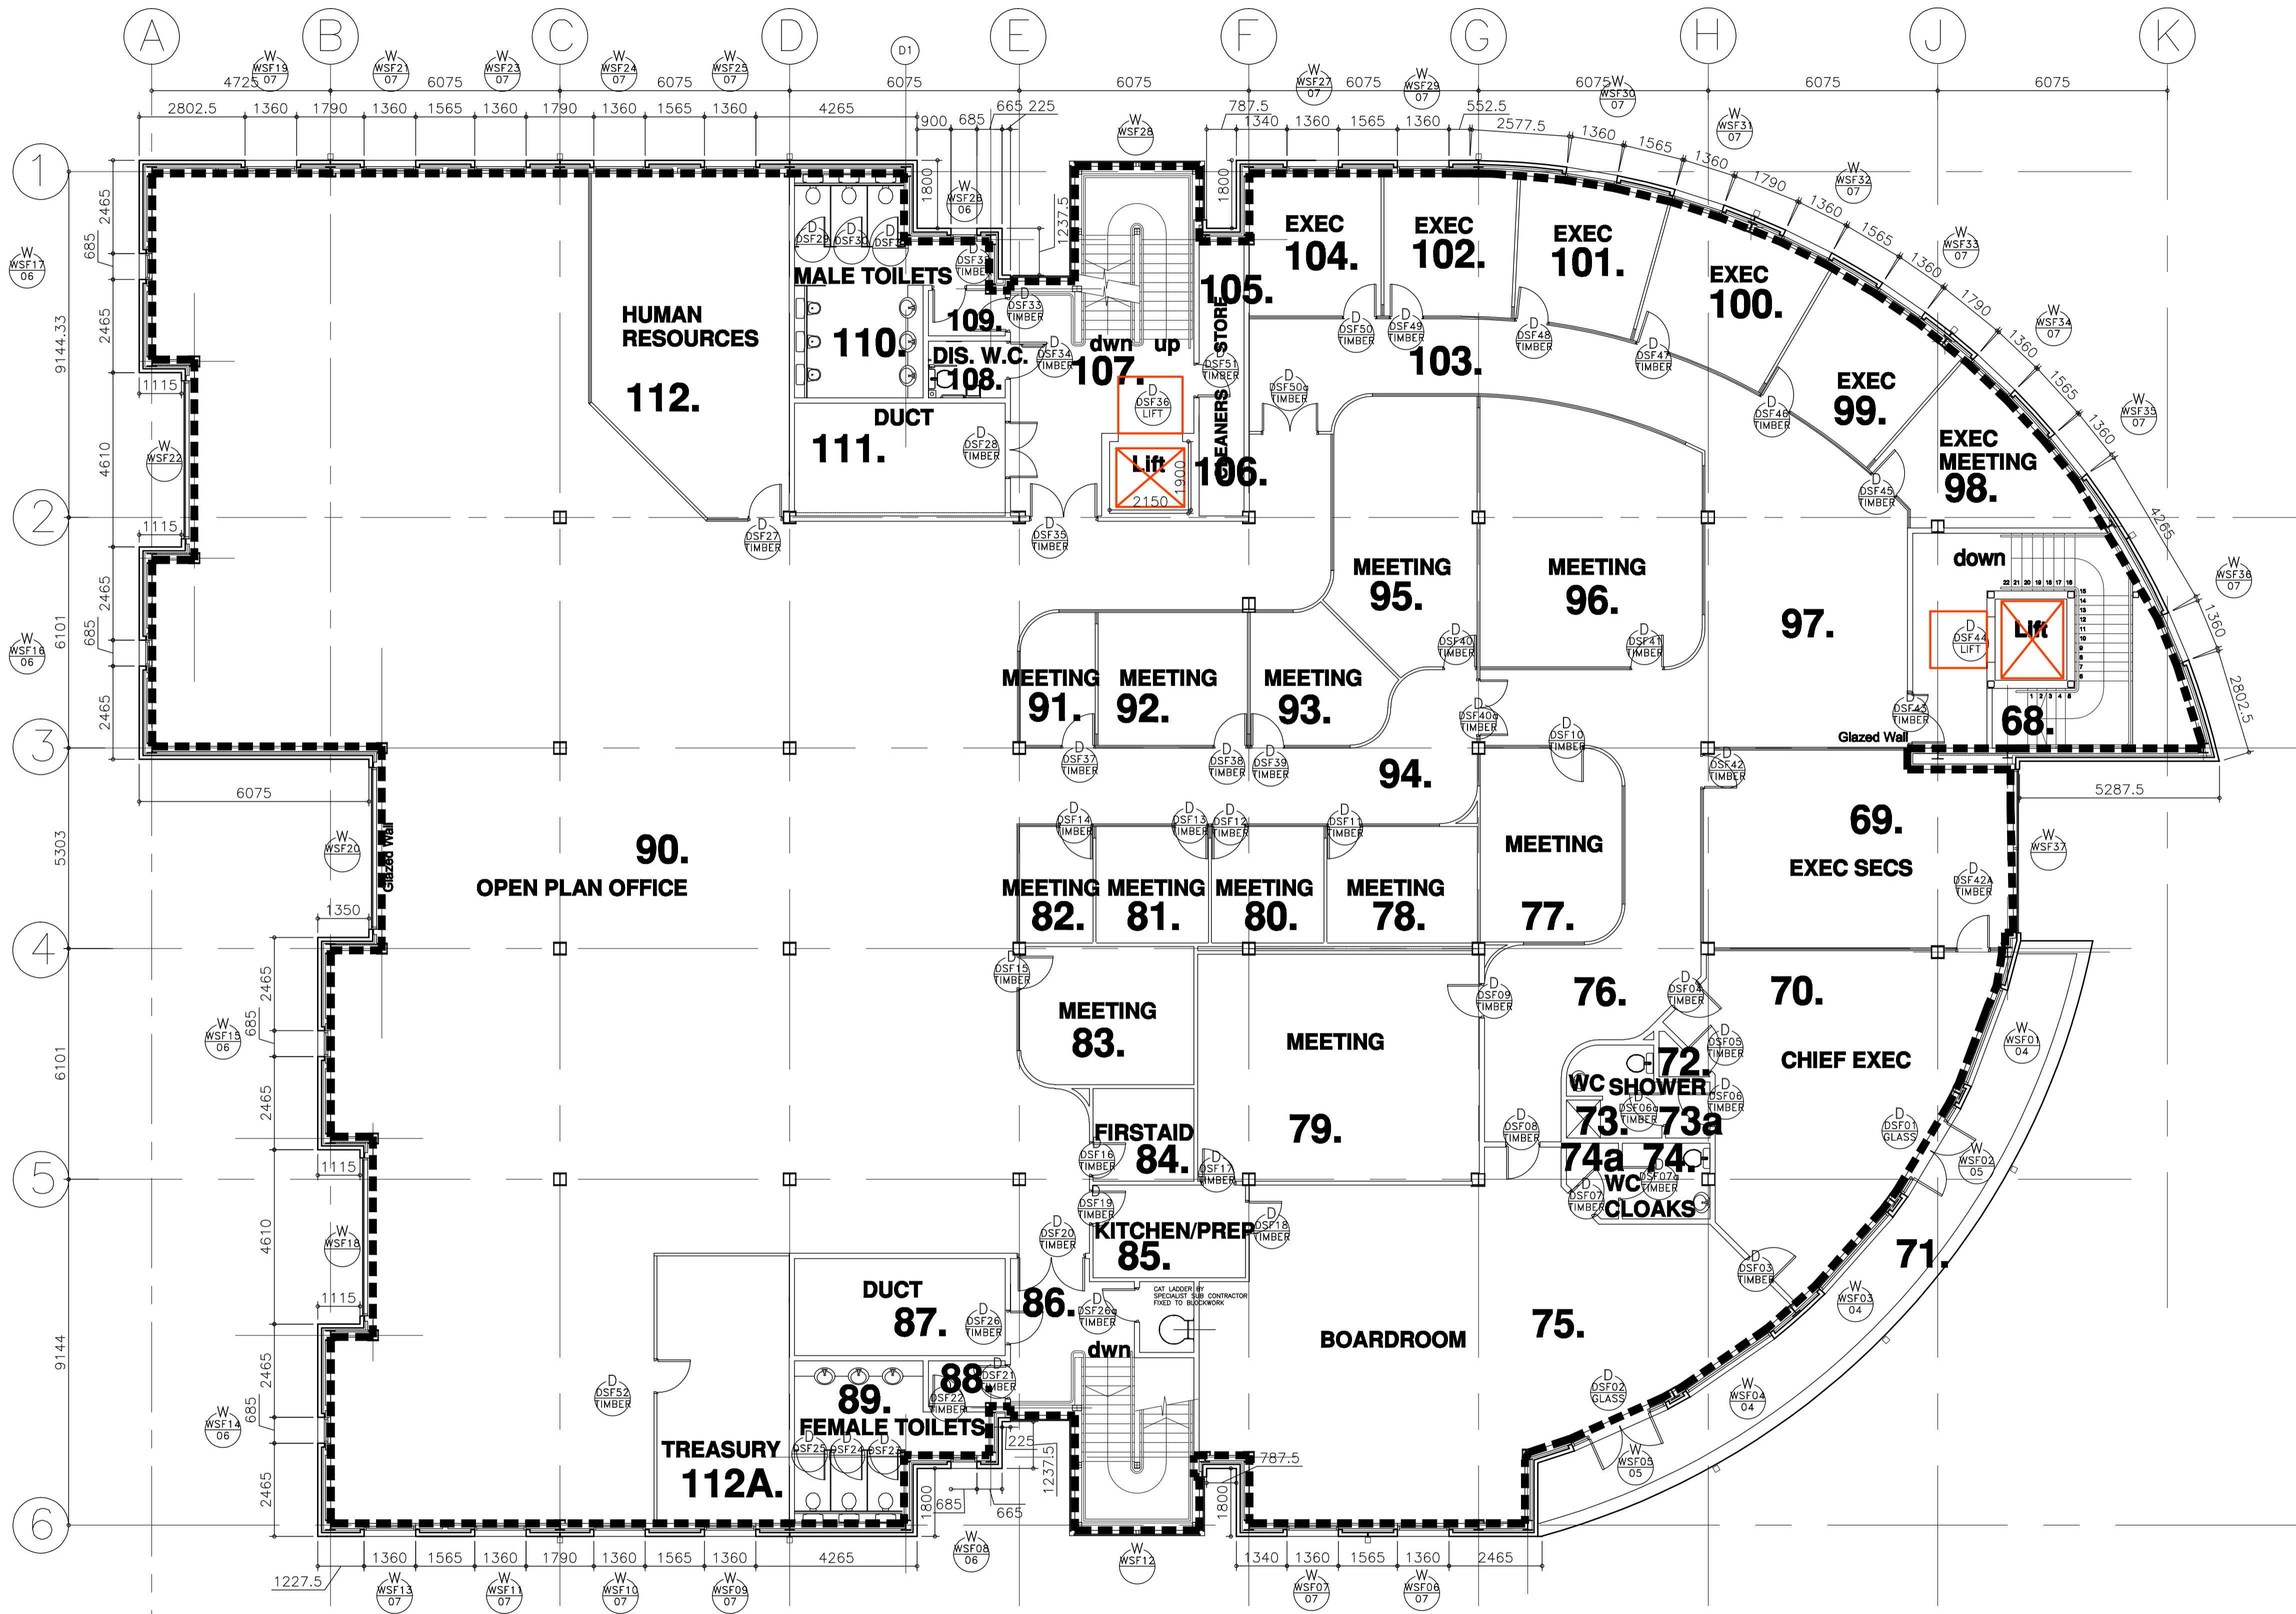

FLOOR AREA 1533 SQM / 16,500 SQFT

AS BUILT DRAWING

PROJECT
 Proposed Office
 Headquarters Development
 Dunslow Road
 Scarborough

CLIENT
 S. Harrison Developments Ltd

TITLE
 Second Floor Plan

JOB NO 5411	DRAWING NO 1007	REVISION J
DATE Feb 2001	SCALE 1:100 @ A1	DRAWN Gary

GRID FILE REFERENCE
 J:\project\5001-6000\5411\construction

24 ST JOHN'S NORTH
 WAKEFIELD WF1 3QA
 Tel: (01924) 291800
 Fax: (01924) 290072
 Email: name@harrispartnership.com

THE HARRIS PARTNERSHIP

Offices also at:
 Manchester
 Newport Pagnell

ARCHITECTS

PROJECT MANAGERS • INTERIOR DESIGNERS