


REVISIONS		
REV A	Wall between room N#s 89 & 703 revised to glass	08:03:01 MG
REV B	AMENDED TO CHANGE ORDER 008 00000001	01:08:01 GH
REV C	Cavity wall added on Grid line 4 between grid lines F & G to hide vertical bracing	20:08:01 MG
REV D	AMENDED TO CHANGE ORDER 008	28:08:01 GH
REV E	AMENDED TO CHANGE ORDERS	16:08:01 GH
REV F	Door N# 08 & 09. Lobbies added in RM N#s 13 & 74	04:01:02 MG
REV G	300mm glass fins added, glazed screen added to room N# 83	14:01:02 MG
REV H	Door N#s 12, 13, 15, 16, 38, & 42 revised in accordance with charge order N# 025	17:01:02 MG
REV J	AS BUILT	21:08:01 GH

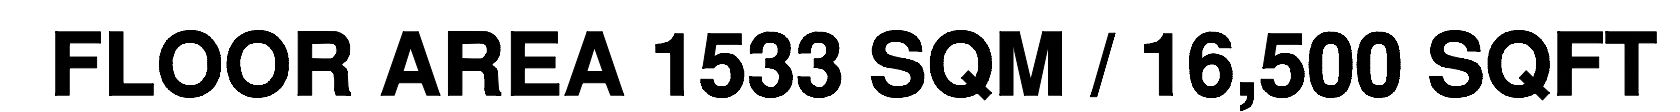

PROJECT

**Proposed Office
Headquarters Development
Dunslow Road
Scarborough**

S. Harrison Developments Ltd

Second Floor Plan

OBJ NO	DRAWING NO
--------	------------

5411	1007
DATE	SCALE

Feb 2001 1:100 ©

AD FILE REFERENCE
 100-45094-200015

11. ST. JOHNS NORTH

WAKEFIELD WF1 3QA
E-1 (01934) 621888

Fax: (01824) 280072

Offices also at:

**Manchester
Newport Pagnell**

ADDITIONAL INFORMATION

ARCHIT

THE
HARRIS
PARTNERSHIP

THE
HARRIS
PARTNERSHIP

1000

1000

ECTS

PROJECT MANAGERS • INTERIOR DESIGNERS